


OMAPERE WHARF REPLACEMENT

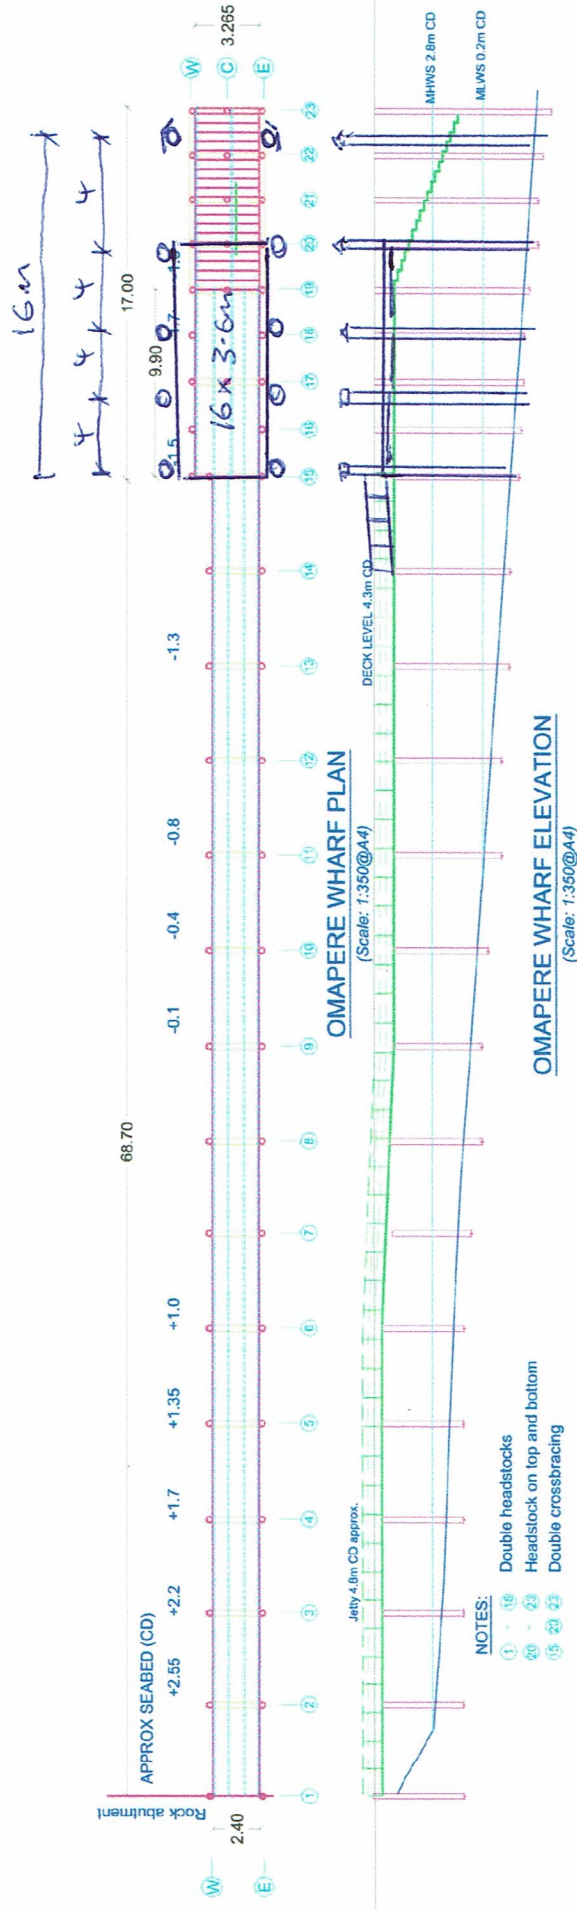

v1.0	Asbuilt Plan	07.05.2021	Survey:	Design: AP	Drawn: AP	Checked:	Date: 07.05.2021	Scale: 1:350@A4	CAD Filename: FNDCCV1.0	Job Title:	FNDCC MARITIME ASSETS	Drawing Title:	OMAPERE BOAT JETTY	Project No:	1036	Rev:	v1.0	Sheet No:	B1	
											Far North Holdings Docks Maritime Assets PO Box 1024 Wellington, New Zealand Ph: (00) 402 5659 Email: info@fndcc.com									